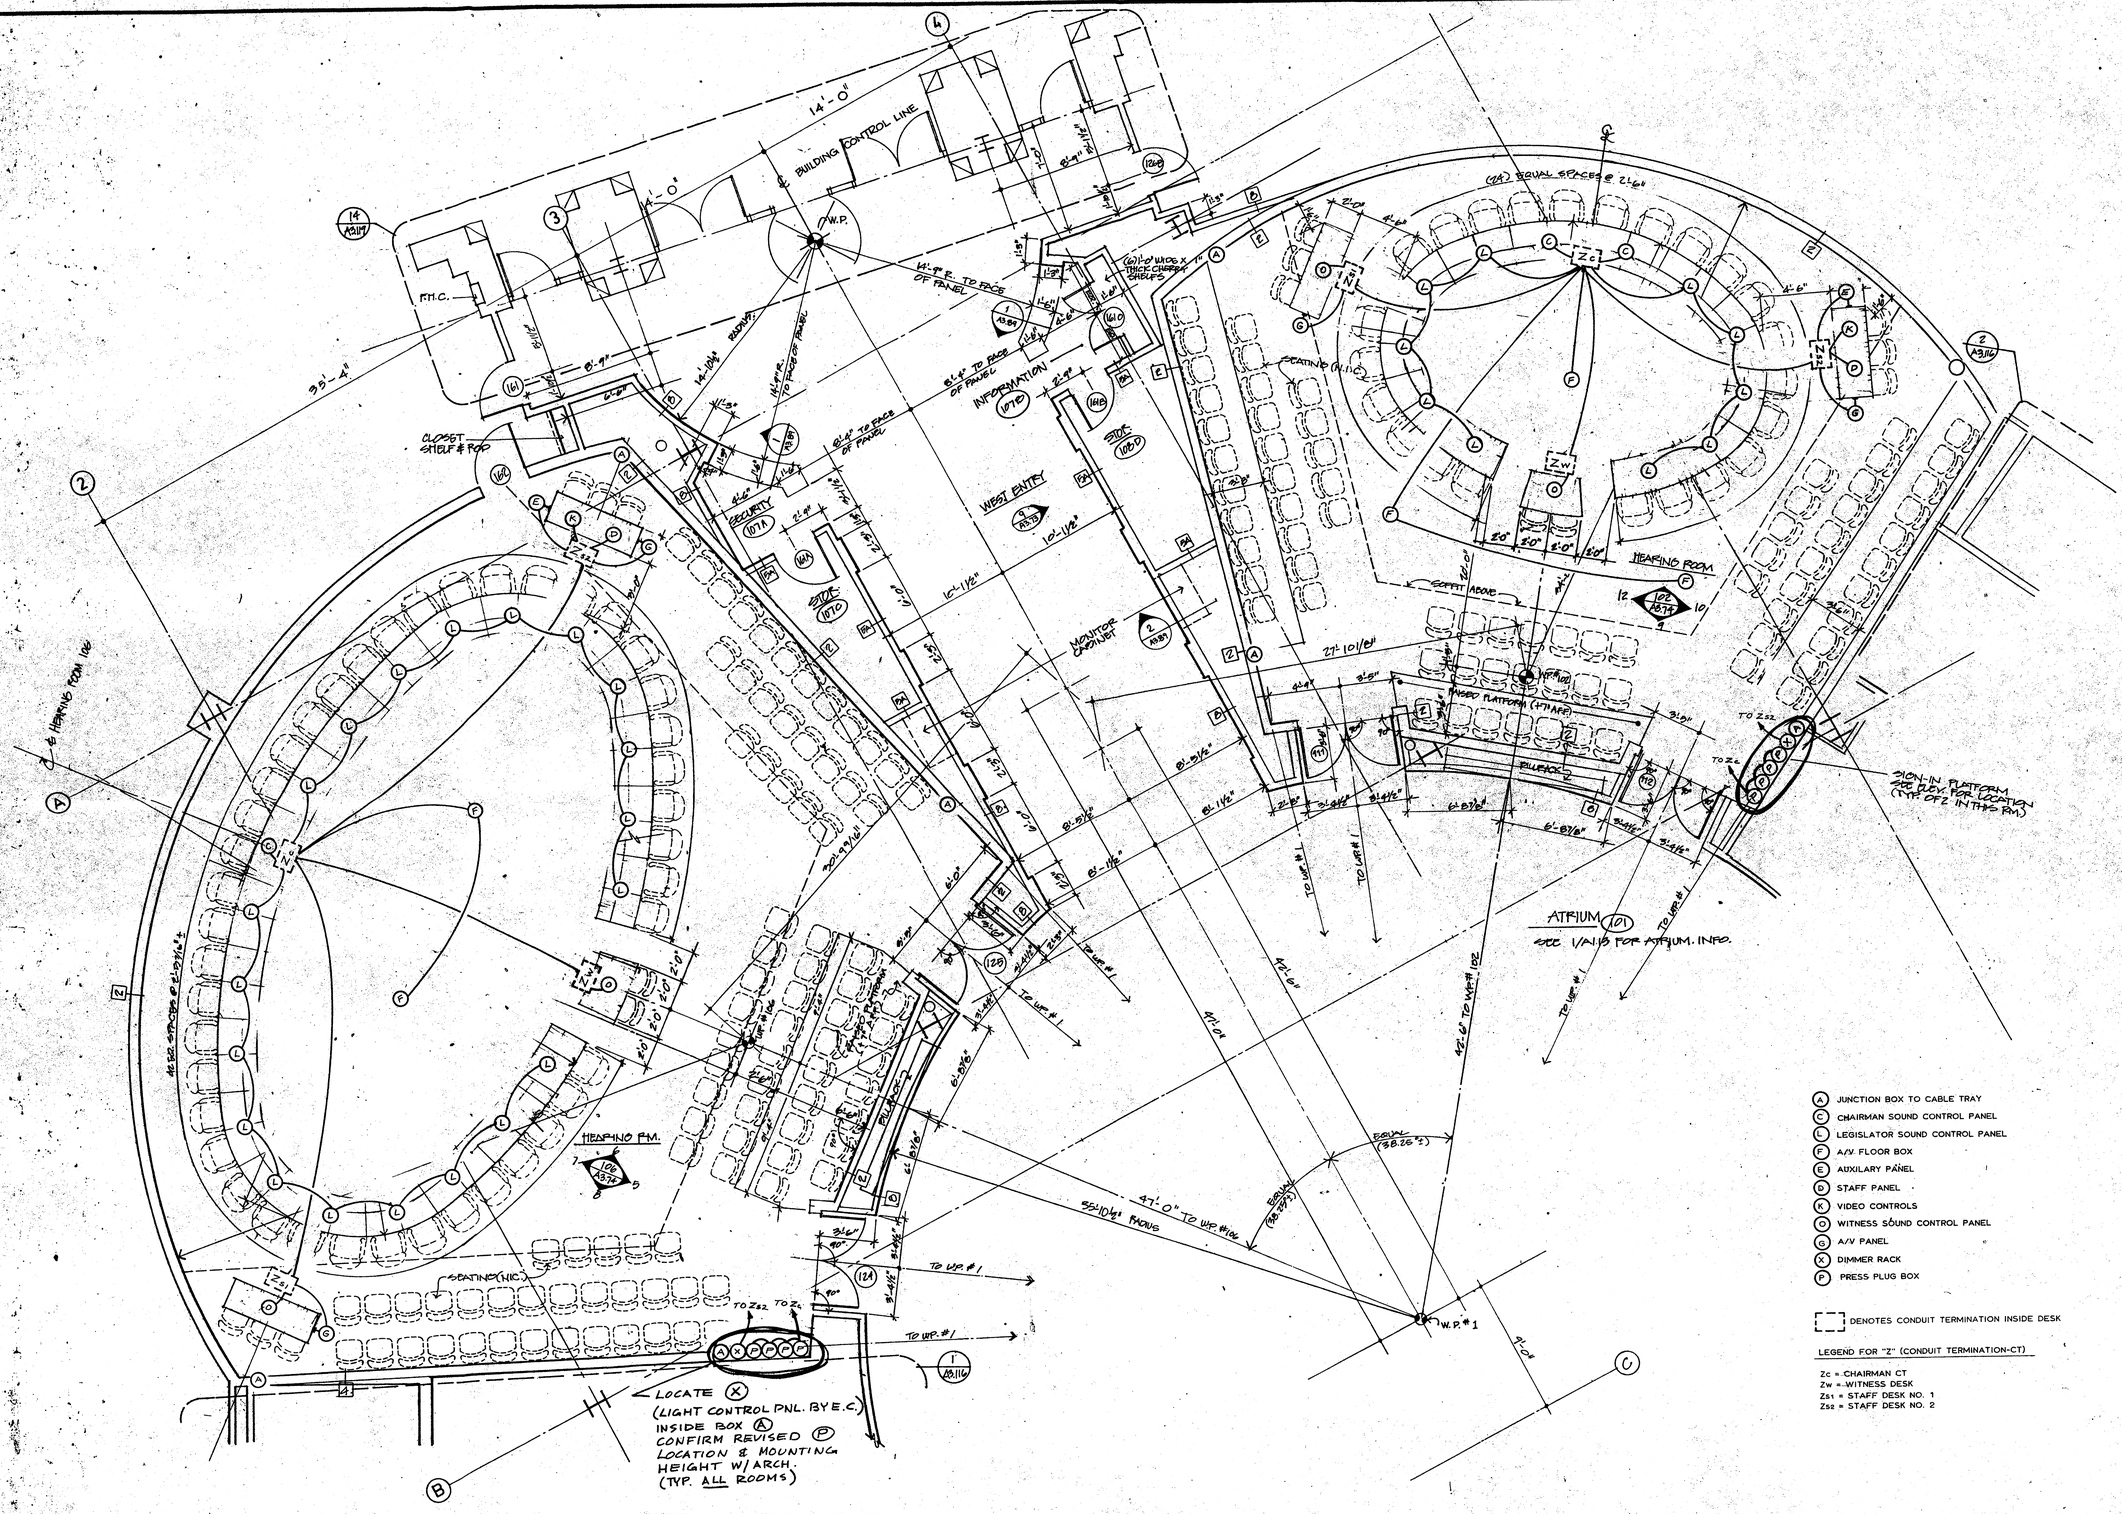

(A) JUNCTION BOX TO CABLE TRAY
(C) CHAIRMAN SOUND CONTROL PANEL
(LC) LEGISLATOR SOUND CONTROL PANEL
(F) A/V FLOOR BOX
(E) AUXILARY PANEL
(S) STAFF PANEL
(X) VIDEO CONTROLS
(O) WITNESS SOUND CONTROL PANEL
(G) A/V PANEL
(X) DIMMER RACK
(P) PRESS PLUG BOX

[ ] DENOTES CONDUIT TERMINATION INSIDE DESK

LEGEND FOR "Z" (CONDUIT TERMINATION-CT)

Zc = CHAIRMAN CT
Zw = WITNESS DESK
Zs1 = STAFF DESK NO. 1
Zs2 = STAFF DESK NO. 2

(1) A9.1B 1/4"=1'-0" HEARING ROOMS 102,106 AND EAST ENTRY 107 FLOOR PLANS

JAFFE ACOUSTICS, INC.
[ ] APPROVED
[ ] DISAPPROVED
[X] APPROVED AS NOTED
[ ] RESUBMIT FOR APPROVAL
BY: M.L.B. DATE: 4/1/87

IMERO FIORENTINO ASSOCIATES
44 WEST 63RD STREET, NEW YORK, NY 10023 212-246-0800

THE DRAWING SUBMITTED HEREWITH HAS BEEN REVIEWED BY THIS OFFICE AND IS:
[ ] APPROVED
[ ] APPROVED AS CORRECTED
[X] APPROVED AS NOTED
[ ] REVISED AND RESUBMIT
[ ] NOT APPROVED

Checking of this drawing is only for conformance with the design concept of the project and compliance with the information given in the Contract Documents. It does not relieve the Contractor of his responsibility for any deviations of the responsibility for proper fabrication or jobsite.

DATE: 4-14-87
FOR IMERO FIORENTINO ASSOCIATES
Susan M. Kelly

NO.	DESCRIPTION	DATE
	REVISIONS	

MIDWEST
ONE SPERTI DRIVE
EDGEWOOD, KY. 41017
TEL.: 606-331-8990
TELEX: 21-4370

TITLE: CONNECTICUT LEGISLATIVE PROJECT
FLOOR PLAN
HEARING ROOM 102 & 106

JOB NO.	25700
DRAWING NO.	25700-23
REVISION CODE:	
SCALE:	
DESIGNED BY:	
DRAWN BY:	DB
CHECKED BY:	
DATE:	3/11/87
APPROVED BY:	Wm. E. Sperti, III

issue
drawing
addendum
date