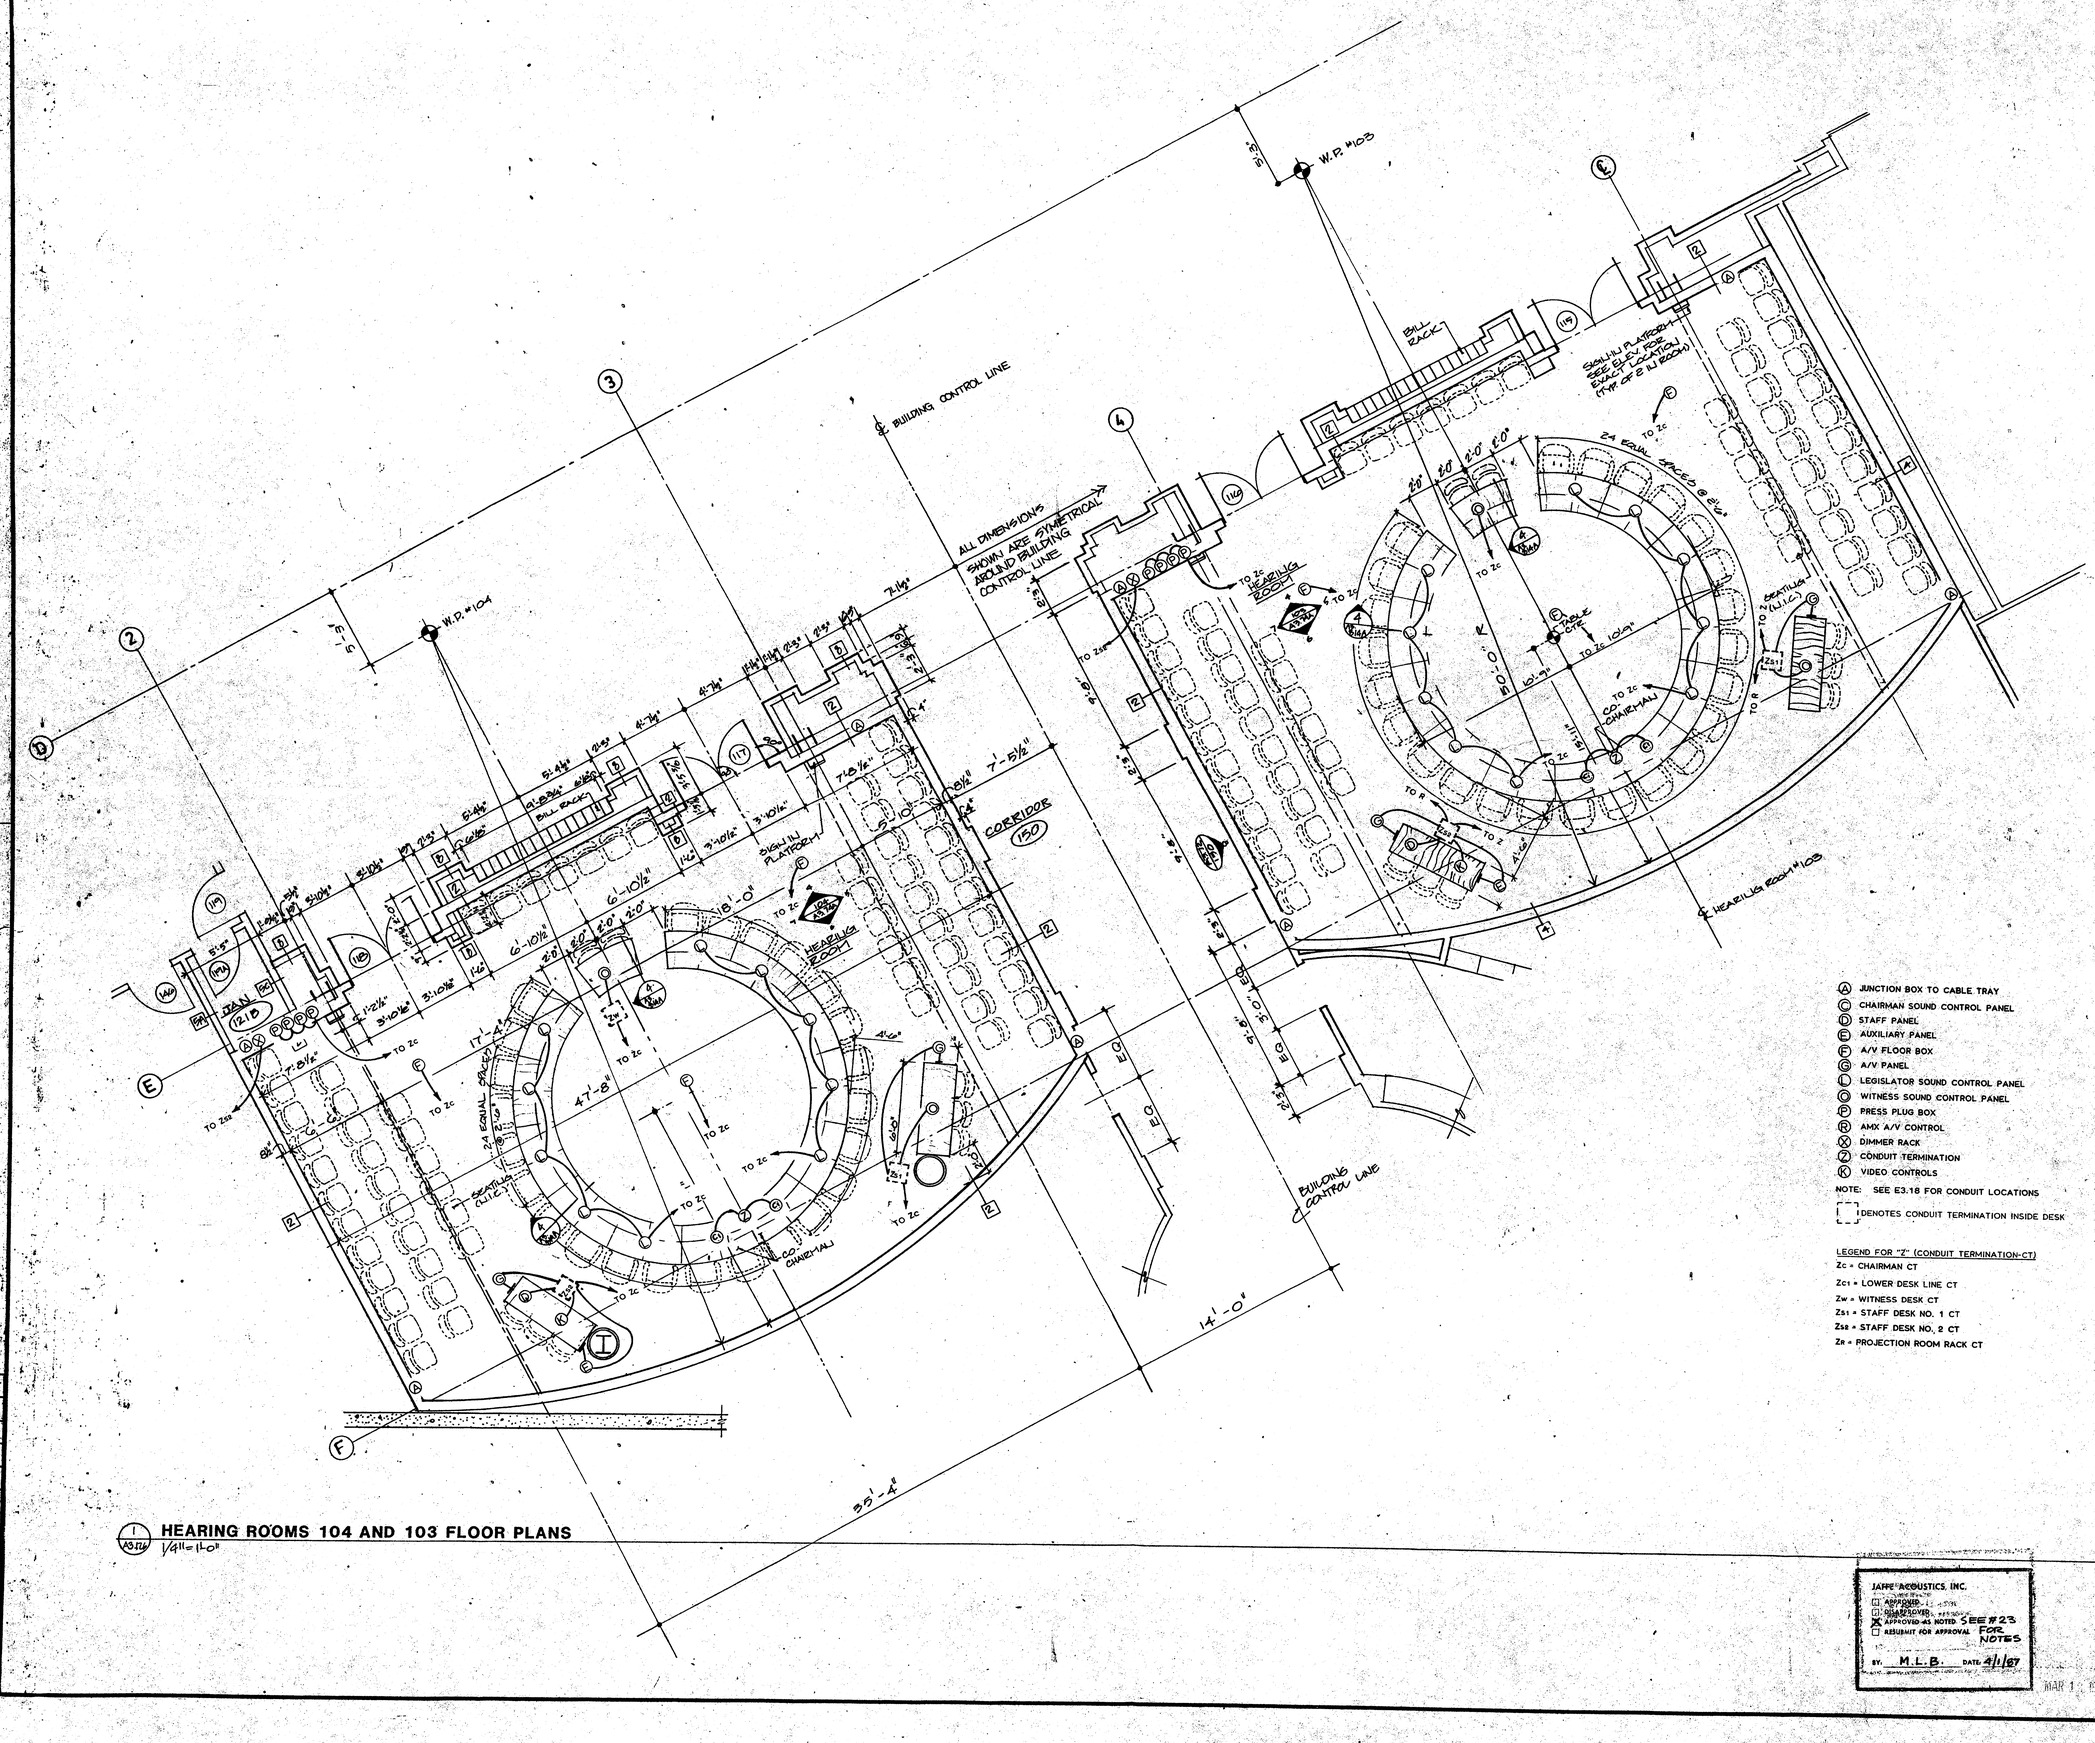

HEARING ROOMS 104 AND 103 FLOOR PLANS

(1/A3.11A) 1/4"=1'-0"

- (A) JUNCTION BOX TO CABLE TRAY
- (C) CHAIRMAN SOUND CONTROL PANEL
- (D) STAFF PANEL
- (E) AUXILIARY PANEL
- (F) A/V FLOOR BOX
- (G) A/V PANEL
- (L) LEGISLATOR SOUND CONTROL PANEL
- (O) WITNESS SOUND CONTROL PANEL
- (P) PRESS PLUG BOX
- (R) AMX A/V CONTROL
- (X) DIMMER RACK
- (Z) CONDUIT TERMINATION
- (K) VIDEO CONTROLS

NOTE: SEE E3.16 FOR CONDUIT LOCATIONS

[ ] DENOTES CONDUIT TERMINATION INSIDE DESK

LEGEND FOR "Z" (CONDUIT TERMINATION-CT)

- Zc = CHAIRMAN CT
- Zc1 = LOWER DESK LINE CT
- Zw = WITNESS DESK CT
- Zs1 = STAFF DESK NO. 1 CT
- Zs2 = STAFF DESK NO. 2 CT
- Ze = PROJECTION ROOM RACK CT

IMERO FIORENTINO ASSOCIATES
CONSULTING ENGINEERS
4 WEST 43rd STREET NEW YORK NY 10036 212 246-0100

THIS DRAWING SUBMITTED HEREWITH HAS BEEN REVIEWED BY THIS OFFICE AND IS:
( ) APPROVED
( ) APPROVED AS CORRECTED
( ) APPROVED AS NOTED
( ) REVISE AND RESUBMIT
( ) NOT APPROVED

Checking of this drawing is only for conformance with the design concept of the project and compliance with the information given in the contract documents. It does not relieve the contractor from his responsibilities for the accuracy of the dimensions and for the construction of the project in a safe and satisfactory manner on site.

DATE 4-14-87
FOR IMERO FIORENTINO ASSOCIATES
Gerard Kelly

JAFFE ACOUSTICS, INC.
[ ] APPROVED
[ ] APPROVED AS NOTED
[X] APPROVED AS NOTED SEE #23 FOR NOTES
[ ] RESUBMIT FOR APPROVAL
BY: M.L.B. DATE: 4/1/87

MAR 1 1987

NO.	DESCRIPTION	DATE

REVISIONS

ONE SPERTI DRIVE
EDGEWOOD, KY. 41017
TEL.: 606-331-8990
TELEX: 21-4370

MIDWEST

TITLE: CONNECTICUT LEGISLATIVE PROJECT
FLOOR PLAN HEARING
ROOM 103 & 104 (A3.126)

JOB NO.: 25700	DESIGNED BY:
DRAWING NO.: 25700-24	DRAWN BY: TONY R. JAMES
COMPUTER CODE:	CHECKED BY:
SCALE: N/A	DATE: 2/10/87
	APPROVED BY:

