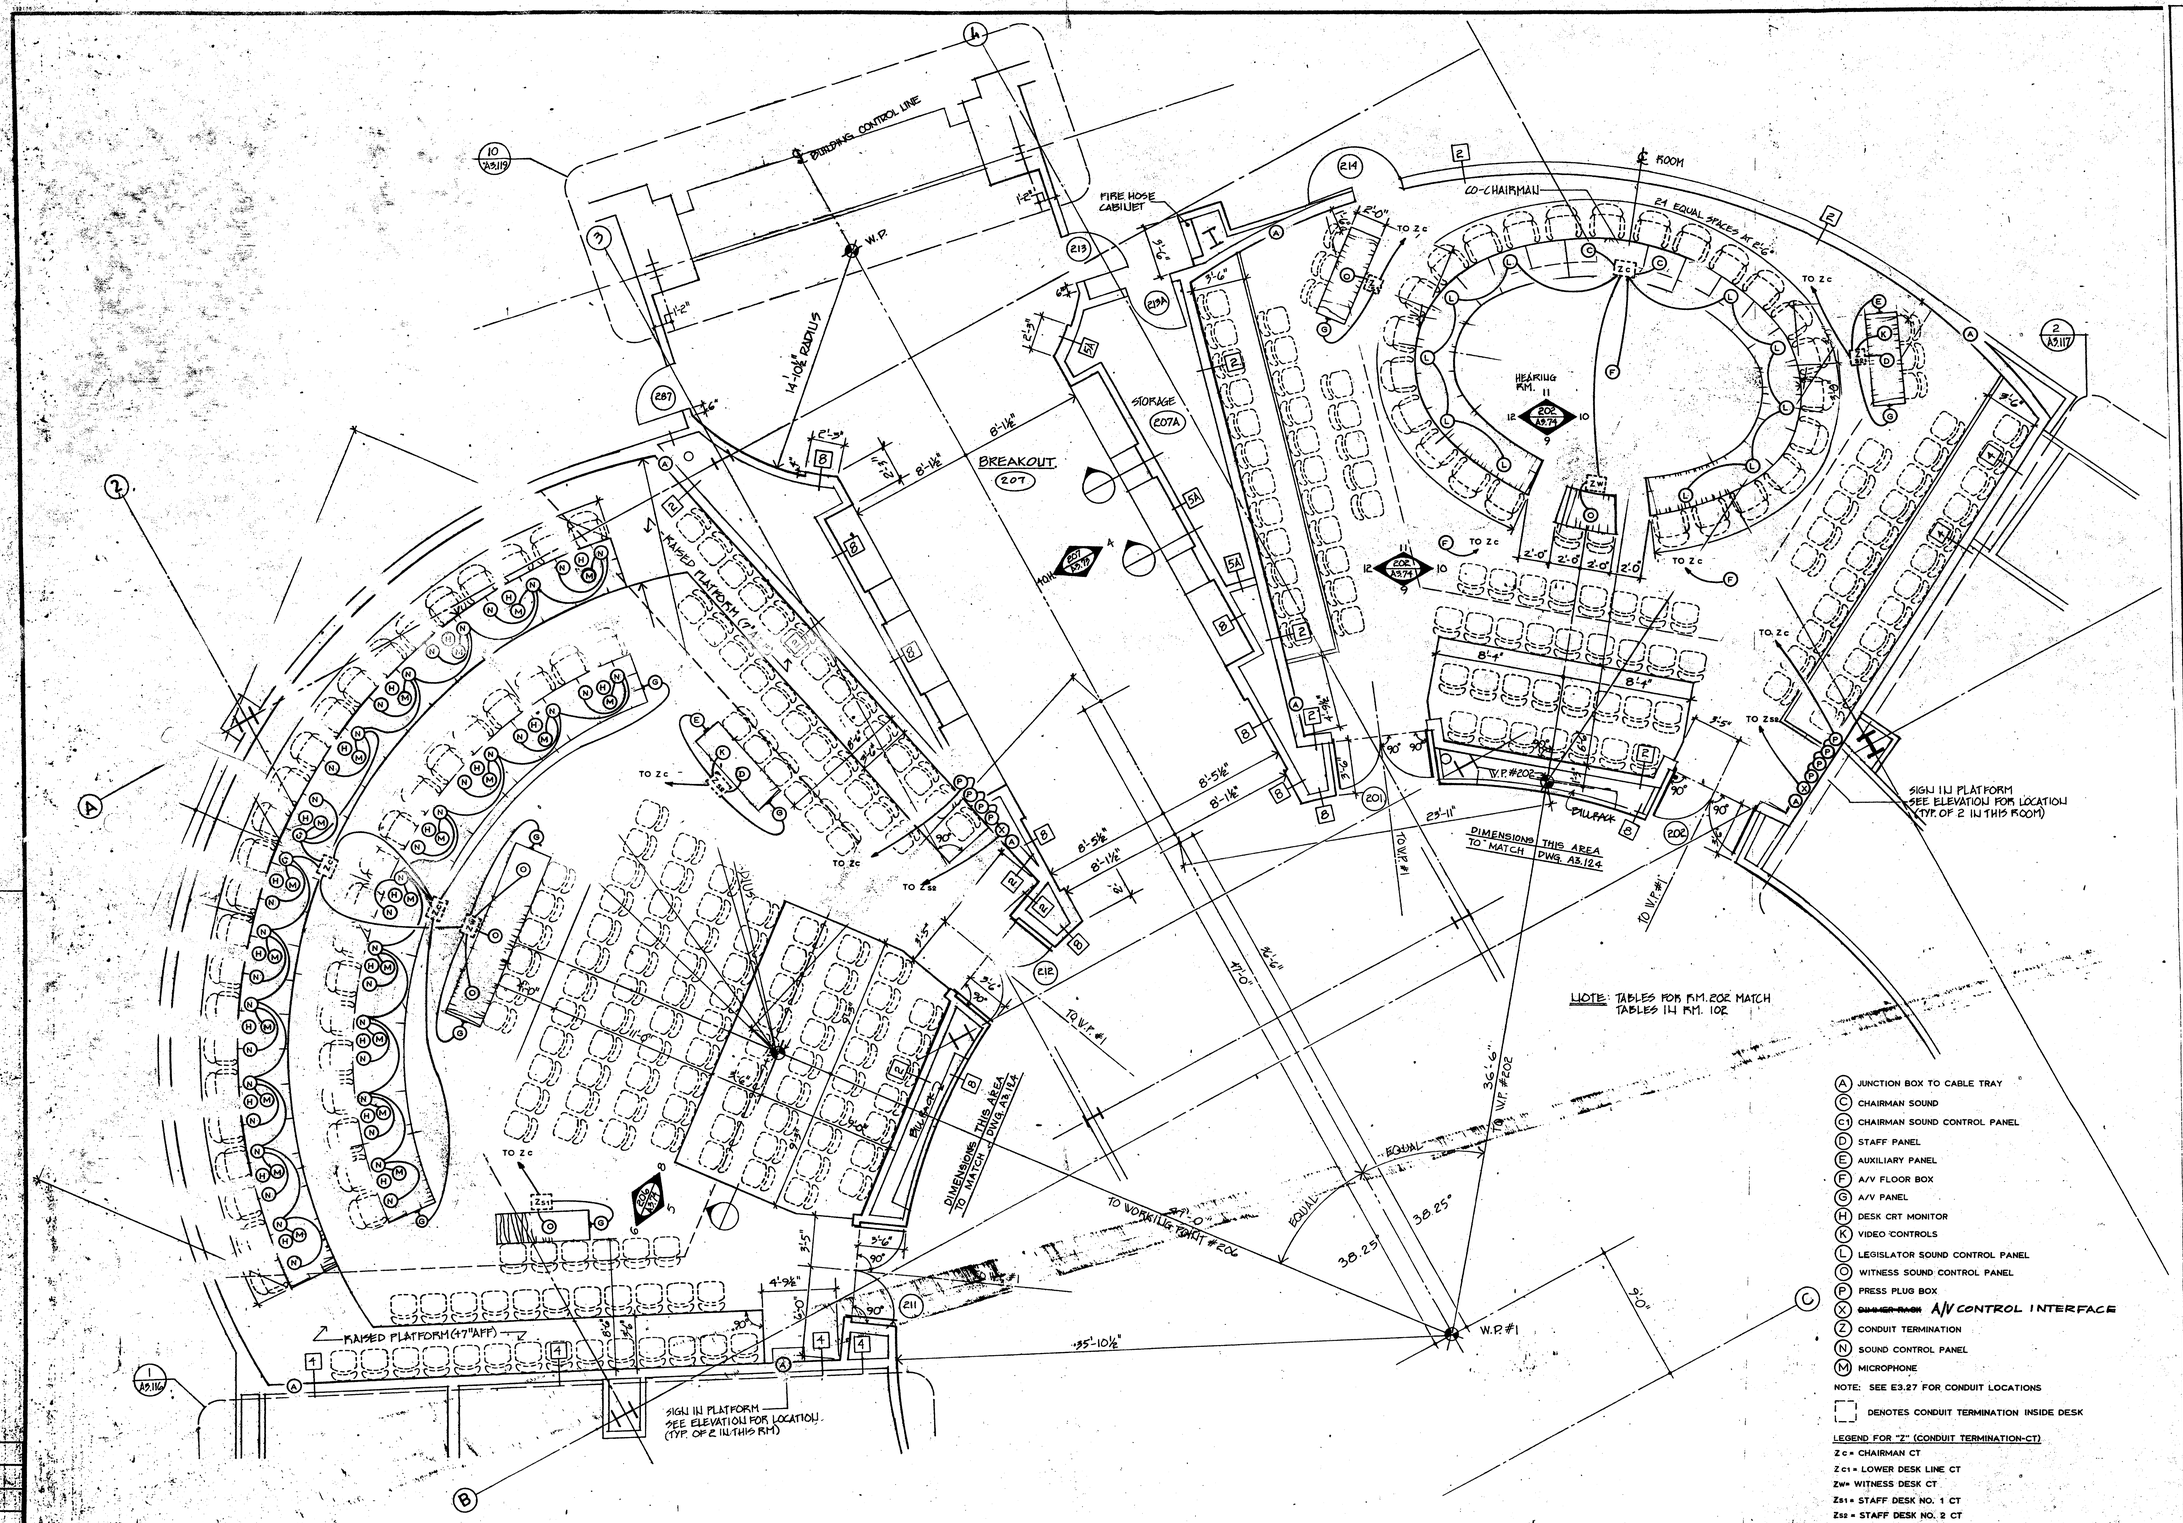

NOTE: TABLES FOR RM. 202 MATCH TABLES IN RM. 102

(A) JUNCTION BOX TO CABLE TRAY
(C) CHAIRMAN SOUND
(C1) CHAIRMAN SOUND CONTROL PANEL
(D) STAFF PANEL
(E) AUXILIARY PANEL
(F) A/V FLOOR BOX
(G) A/V PANEL
(H) DESK CRT MONITOR
(K) VIDEO CONTROLS
(L) LEGISLATOR SOUND CONTROL PANEL
(O) WITNESS SOUND CONTROL PANEL
(P) PRESS PLUG BOX
(X) ~~DIMMER RACK~~ A/V CONTROL INTERFACE
(Z) CONDUIT TERMINATION
(N) SOUND CONTROL PANEL
(M) MICROPHONE

NOTE: SEE E3.27 FOR CONDUIT LOCATIONS

[ ] DENOTES CONDUIT TERMINATION INSIDE DESK

LEGEND FOR "Z" (CONDUIT TERMINATION-CT)
Zc = CHAIRMAN CT
Zc1 = LOWER DESK LINE CT
Zw = WITNESS DESK CT
Zs1 = STAFF DESK NO. 1 CT
Zss = STAFF DESK NO. 2 CT

(1B) HEARING ROOMS 206 AND 202 FLOOR PLANS
(A3.117) 1/8" = 1'-0"

JAFFE ACOUSTICS, INC.
☐ APPROVED
☐ DISAPPROVED
☒ APPROVED AS NOTED SEE #23 FOR NOTES
☐ RESUBMIT FOR APPROVAL
BY M.L.B. DATE 4/1/87

MAR 13 1987

MEYER, FIDLER AND ASSOCIATES
44 WEST 53RD STREET NEW YORK, NY 10023 212-586-0100

THE DRAWING SUBMITTED HEREWITH HAS BEEN REVIEWED BY THIS OFFICE AND IS:
( ) APPROVED
( ) APPROVED AS CORRECTED
( ) APPROVED AS NOTED
( ) REVISE AND RESUBMIT
( ) NOT APPROVED

Checking of the shop drawing is only for conformance with the design concept of the project and compliance with the information given in the contract documents. It does not relieve the contractor of his responsibility for dimensions, quantities, and coordination of the responsibilities of the other persons on site.

DATE 4-14-87
FOR MEYER, FIDLER AND ASSOCIATES

NO.	DESCRIPTION	DATE
	REVISIONS	

MIDWEST
ONE SPERTI DRIVE
EDGEWOOD, KY. 41017
TEL.: 606-331-8990
TELEX: 21-4370

TITLE: CONNECTICUT LEGISLATIVE PROJECT
FLOOR PLAN
HEARING ROOM 202 & 206

JOB NO.: 25700	DESIGNED BY:
DRAWING NO.: 25700-26	DRAWN BY: MIKE JONES
DATE: 3/10/87	CHECKED BY:
SCALE: N/A	APPROVED BY: 3/10/87