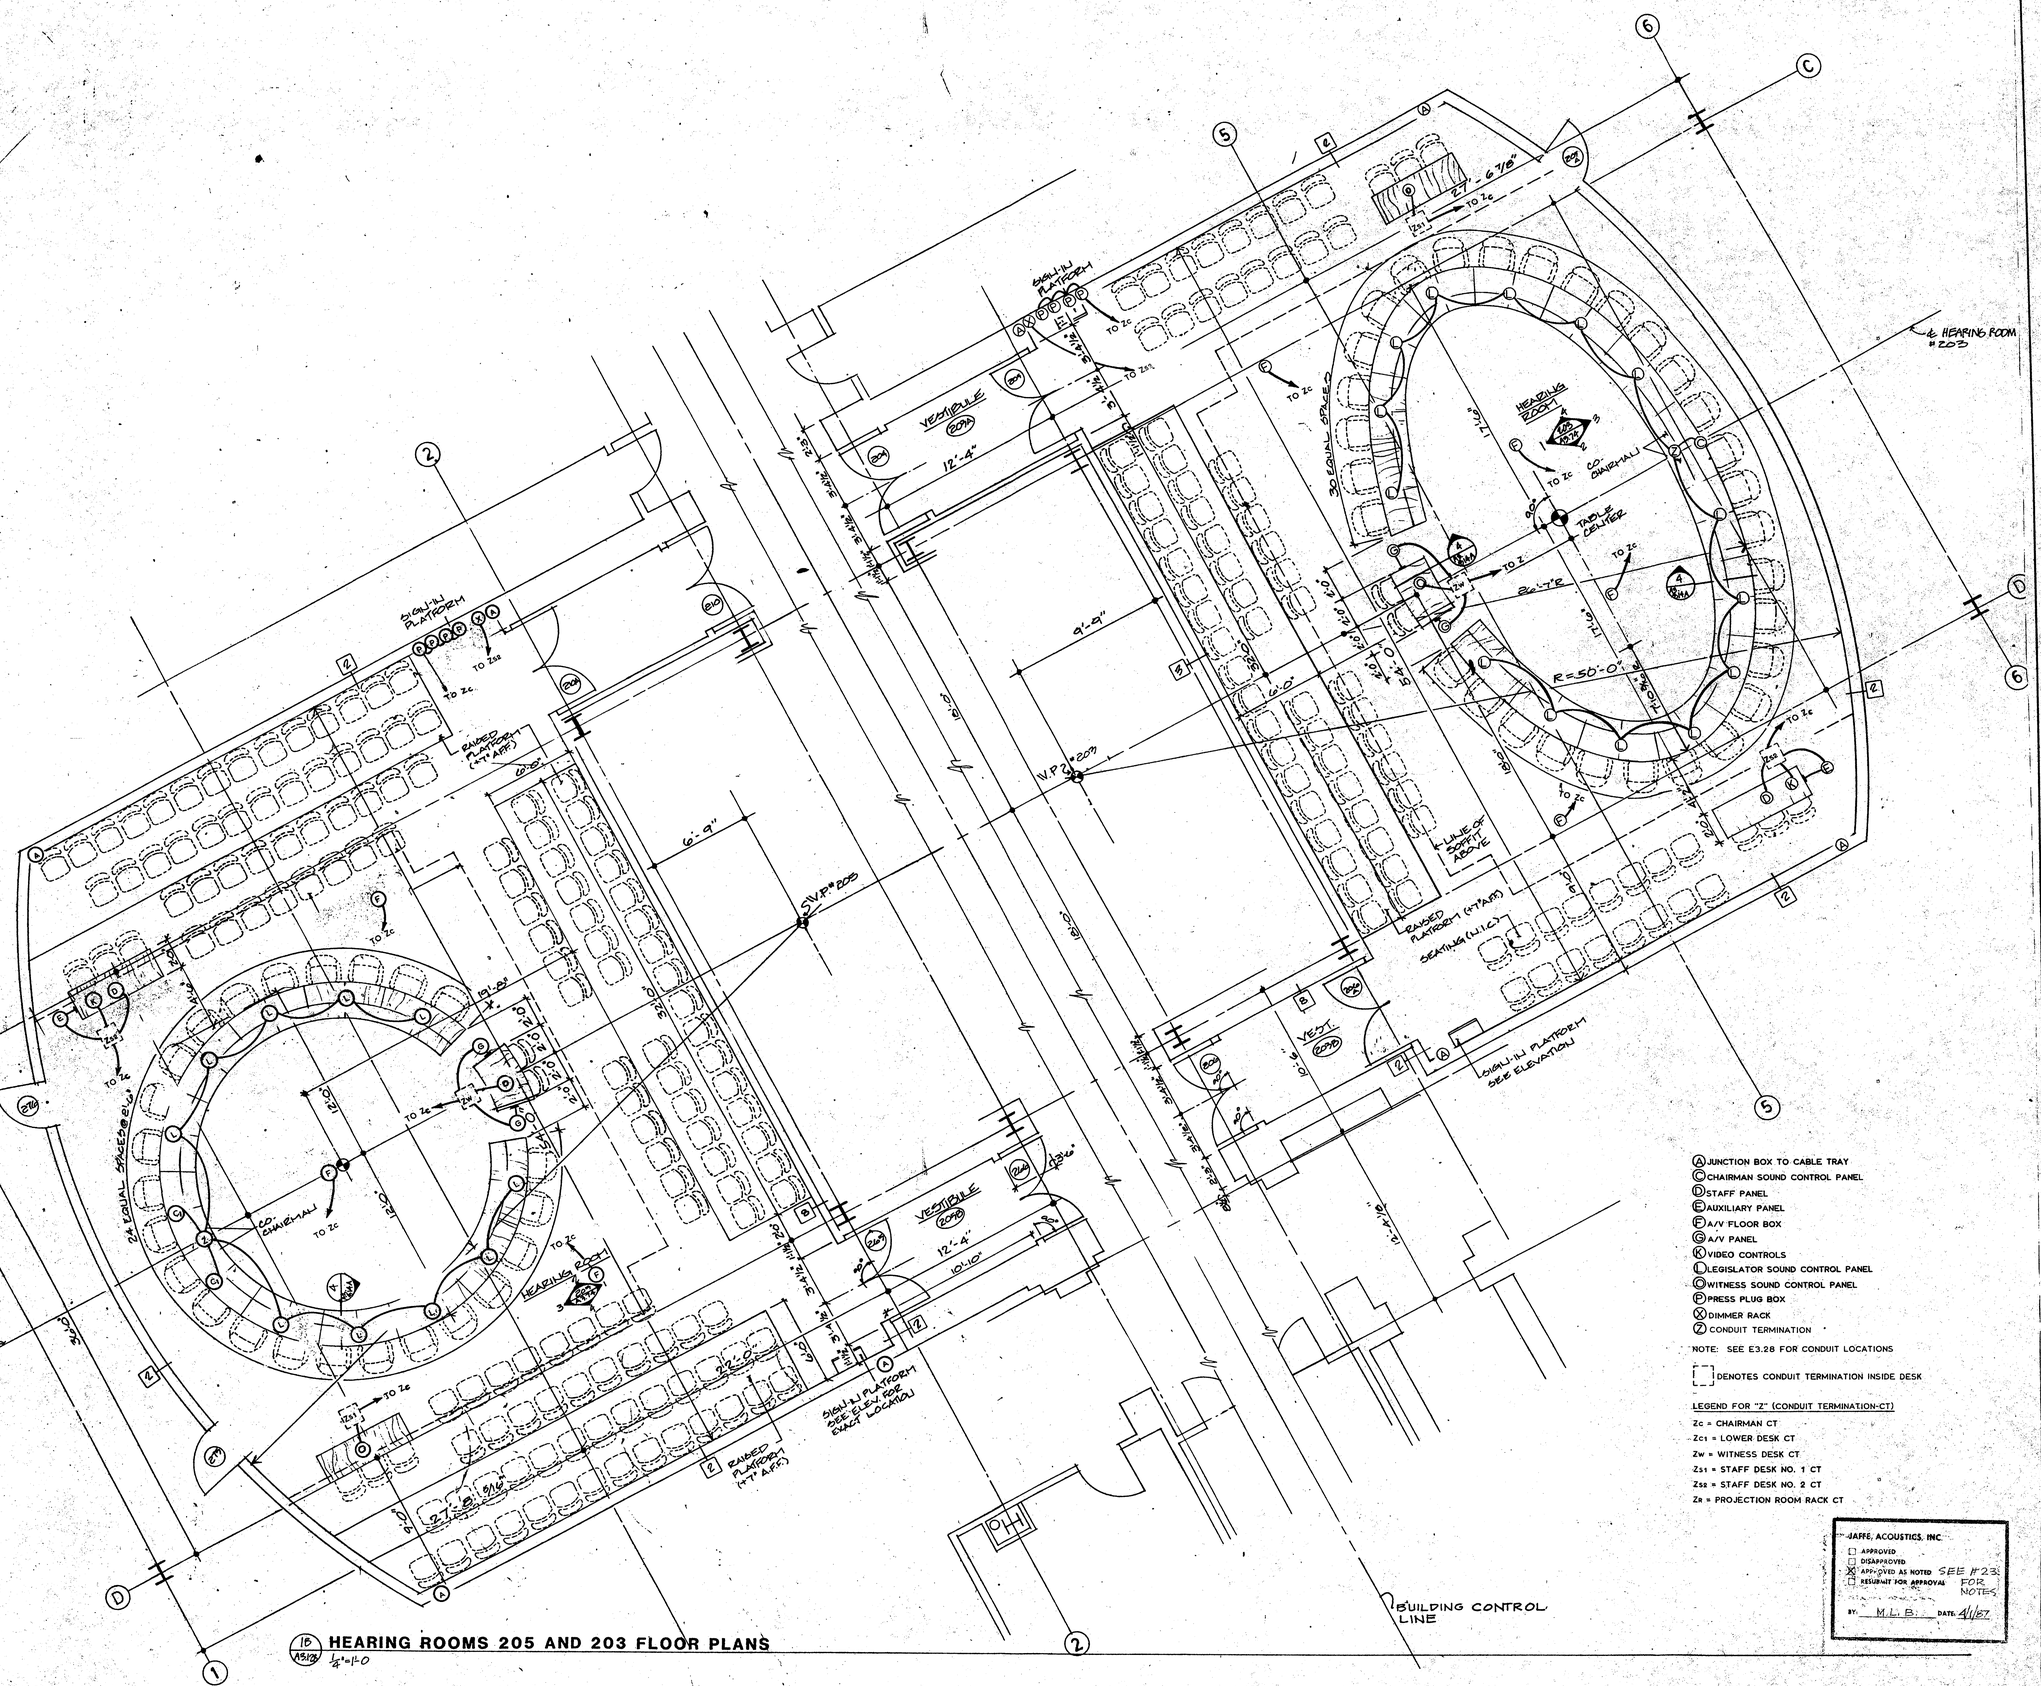

(A) JUNCTION BOX TO CABLE TRAY
(C) CHAIRMAN SOUND CONTROL PANEL
(D) STAFF PANEL
(E) AUXILIARY PANEL
(F) A/V FLOOR BOX
(G) A/V PANEL
(K) VIDEO CONTROLS
(L) LEGISLATOR SOUND CONTROL PANEL
(O) WITNESS SOUND CONTROL PANEL
(P) PRESS PLUG BOX
(X) DIMMER RACK
(Z) CONDUIT TERMINATION

NOTE: SEE E3.28 FOR CONDUIT LOCATIONS

[ ] DENOTES CONDUIT TERMINATION INSIDE DESK

LEGEND FOR "Z" (CONDUIT TERMINATION-CT)

Zc = CHAIRMAN CT
Zc1 = LOWER DESK CT
Zw = WITNESS DESK CT
Zs1 = STAFF DESK NO. 1 CT
Zs2 = STAFF DESK NO. 2 CT
Za = PROJECTION ROOM RACK CT

JAFFE, ACOUSTICS, INC.
☐ APPROVED
☐ DISAPPROVED
☒ APPROVED AS NOTED SEE #23 FOR NOTES
☐ RESUBMIT FOR APPROVAL
BY: M.L.B. DATE: 4/1/87

(1B) HEARING ROOMS 205 AND 203 FLOOR PLANS
A3.128 1/4"=1'-0

MAR 12 1987

base
overlay
screen
mult

HARRY FIORENTINO ASSOCIATES
44 WEST 62ND STREET, NEW YORK, NY 10023 212 246-8900

THE DRAWING SUBMITTED HEREWITH HAS BEEN REVIEWED BY THE DISTRICT AND IS:
( ) APPROVED
( ) APPROVED AS CORRECTED
( ) APPROVED AS NOTED
( ) RESUBMIT AND RESTAMPT
( ) NOT APPROVED

Checking of this drawing is only for conformance with the division referenced in the drawing and for compliance with the information given in the design criteria and other documents prepared for this project by others. Compliance with all requirements of the responsible architect or engineer of record is the responsibility of others.

DATE: 4-14-87
FOR HARRY FIORENTINO ASSOCIATES
Frank Kelly

NO.	DESCRIPTION	DATE
	REVISIONS	

MIDWEST
ONE SPERTI DRIVE
EDGEWOOD, KY. 41017
TEL.: 606-331-8990
TELEX: 21-4370

TITLE: CONNECTICUT LEGISLATIVE PROJECT
FLOOR PLAN HEARING ROOM
203 & 205 (A3.128)

JOB NO: 25700	DESIGNED BY:
DRAWING No.: 25700-27	DRAWN BY: TONY R. JAMES
COMPUTER CORE:	CHECKED BY:
SCALE: N.A. DATE: 3/10/87	APPROVED BY: Wm. C. Burke 4/6/87