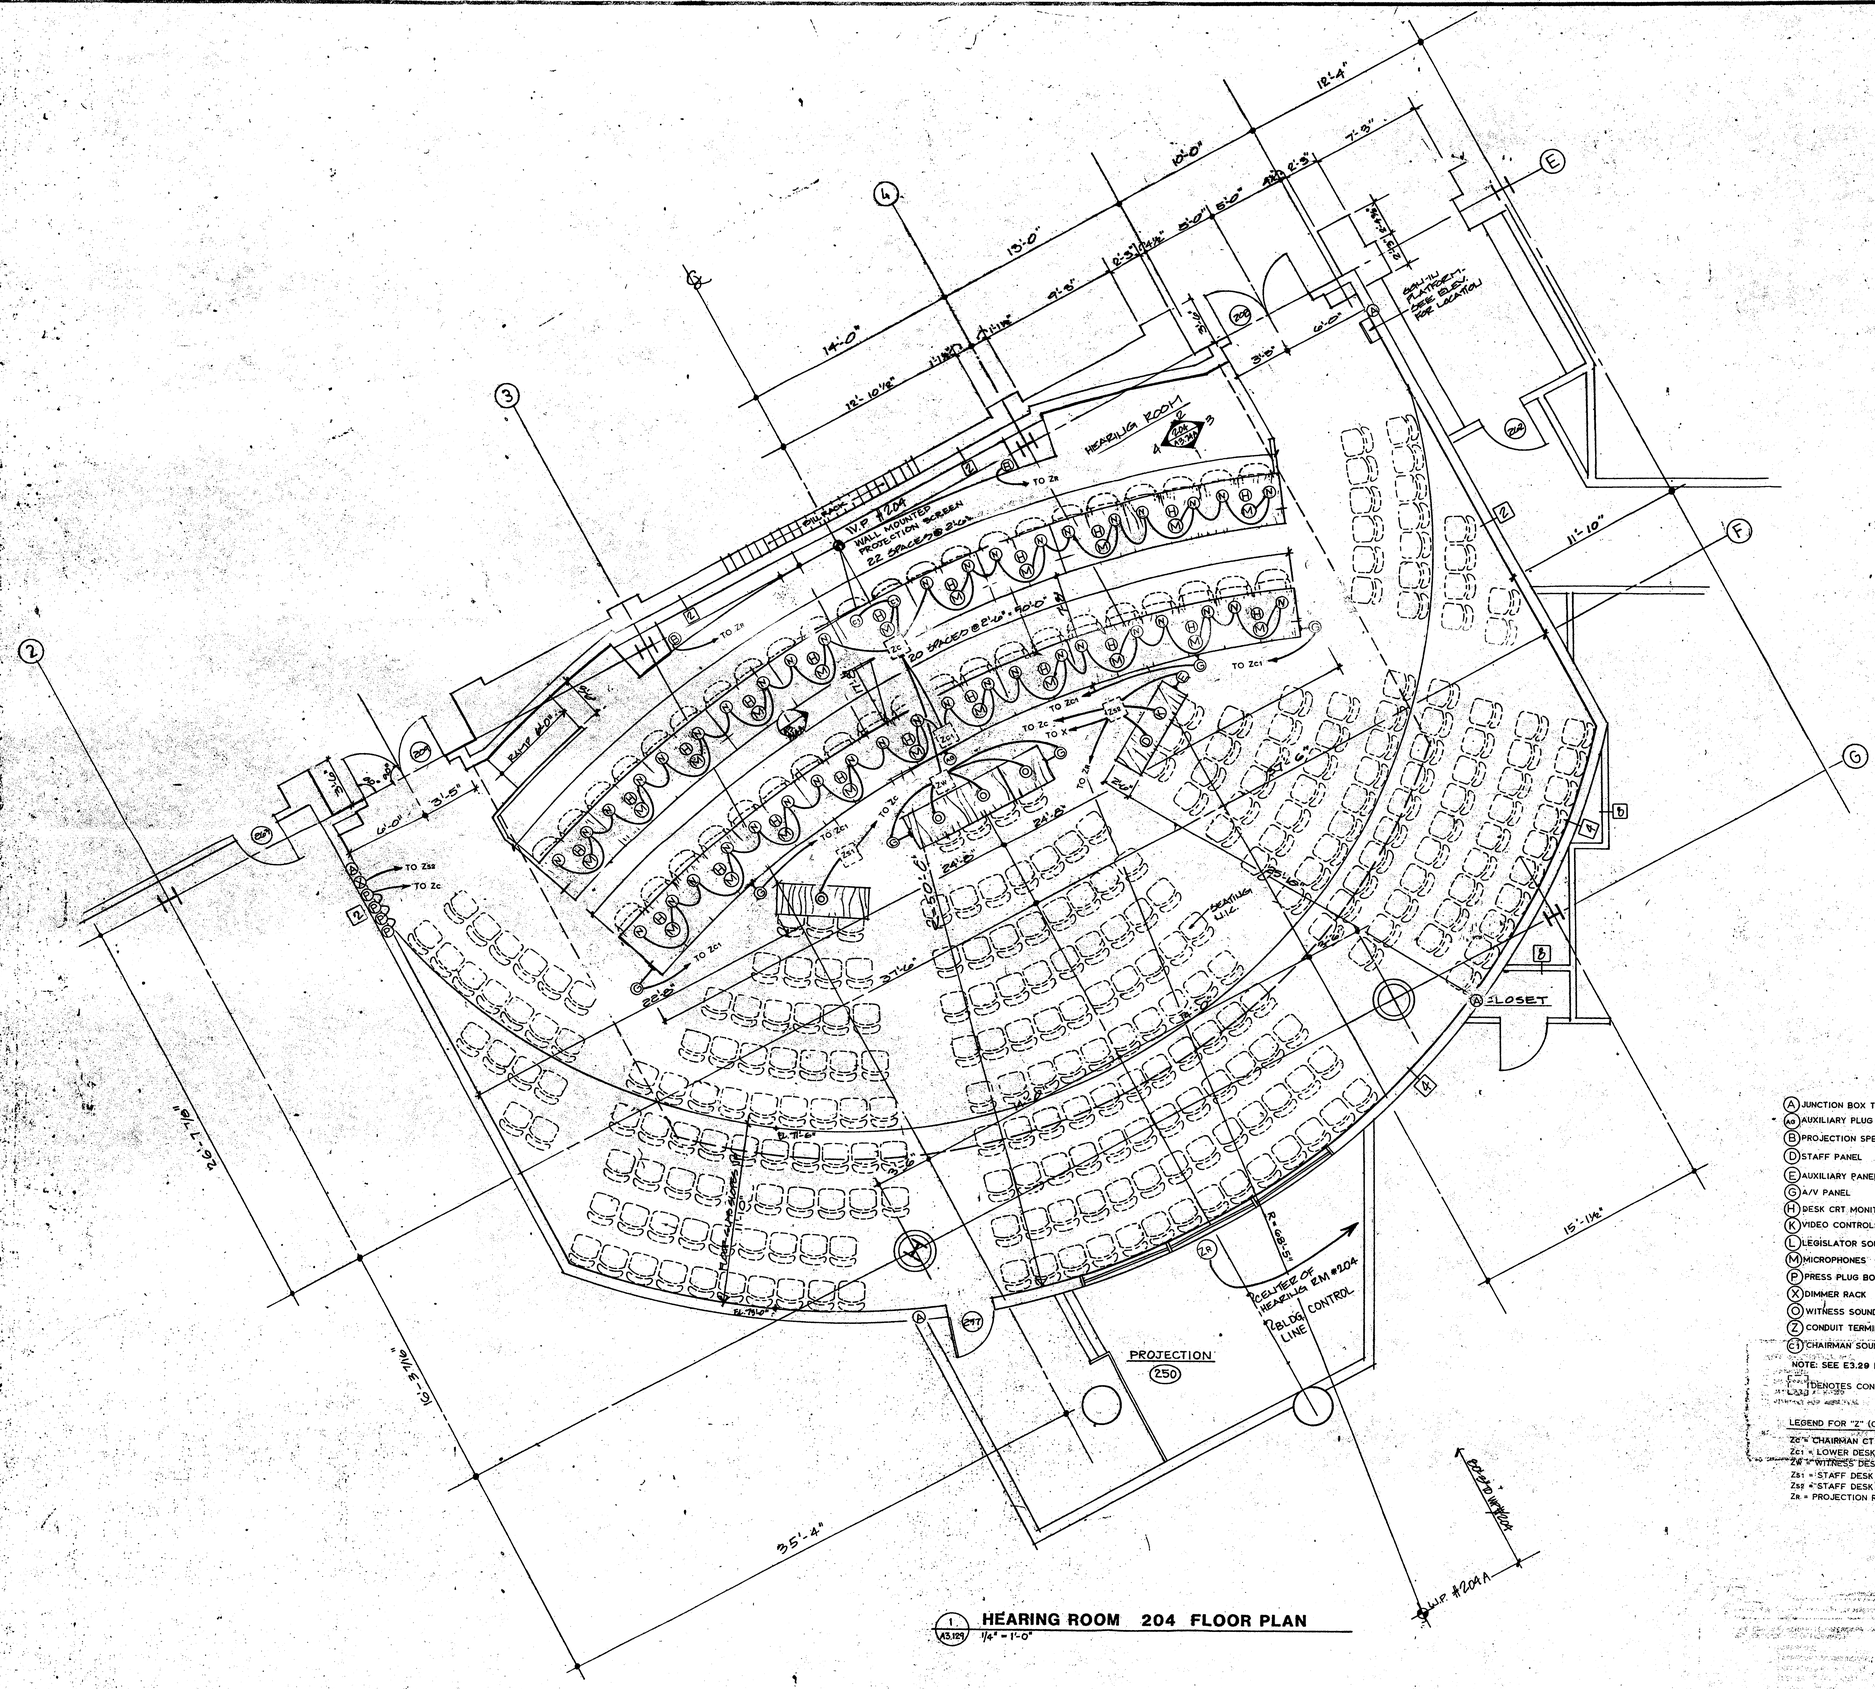

1 A3.129 **HEARING ROOM 204 FLOOR PLAN**
1/4" = 1'-0"

- (A) JUNCTION BOX TO CABLE TRAY
- (AB) AUXILIARY PLUG BOX
- (B) PROJECTION SPEAKER
- (D) STAFF PANEL
- (E) AUXILIARY PANEL
- (G) A/V PANEL
- (H) DESK CRT MONITOR
- (K) VIDEO CONTROLS
- (L) LEGISLATOR SOUND CONTROL PANEL
- (M) MICROPHONES
- (P) PRESS PLUG BOX
- (X) DIMMER RACK
- (O) WITNESS SOUND CONTROL PANEL
- (Z) CONDUIT TERMINATION (CT)
- (C1) CHAIRMAN SOUND CONTROL PANEL

NOTE: SEE E3.29 FOR CONDUIT LOC.

( ) DENOTES CONDUIT TERMINATION INSIDE DESK

LEGEND FOR "Z" (CONDUIT TERMINATION-CT)

Zc = CHAIRMAN CT
Zc1 = LOWER DESK LINE CT
Zw = WITNESS DESK CT
Zs1 = STAFF DESK NO. 1 CT
Zs2 = STAFF DESK NO. 2 CT
ZR = PROJECTION ROOM RACK CT

JAFFE ACOUSTICS, INC.
☐ APPROVED
☐ DISAPPROVED
☒ APPROVED AS NOTED SEE #23 FOR NOTES
☐ RESUBMIT FOR APPROVAL
BY: M.L.B. DATE: 4/1/87

44 WEST 63RD STREET, NEW YORK, NY 10023 212-246-0800

THE DRAWING SUBMITTED HEREWITH HAS BEEN REVIEWED BY THIS OFFICE AND IS:
( ) APPROVED
( ) APPROVED AS CORRECTED
(✓) APPROVED AS NOTED
( ) REVISE AND RESUBMIT
( ) NOT APPROVED

Checkprint of this drawing is submitted for conformance with the design concept of the project and compliance with the information given in the contract documents. Contractor is responsible for confirming and correlating all dimensions, quantities and conditions at the job site, coordinating the work of all trades and performing all work safely and satisfactorily. Review of this drawing is for general conformance to design concept of the project only.

DATE 4-14-87
FOR JIMENO FIORENTINO ASSOCIATES
Frank Kelly

NO.	DESCRIPTION	DATE

REVISIONS

MIDWEST
ONE SPERTI DRIVE
EDGEWOOD, KY. 41017
TEL.: 606-331-8880
TELEX: 21-4370

TITLE: CONNECTICUT LEGISLATIVE PROJECT
FLOOR PLAN HEARING ROOM 204
(A3.129)

JOB NO.: 25700
DRAWING NO.: 25700-28
COMPUTER CODE:
FILE: N/A
DATE: 3/18/87

DESIGNED BY:
DRAWN BY: MARK VOORHEES
CHECKED BY:
APPROVED BY: William E. Jaffe

Base Drawing
Screen
Data