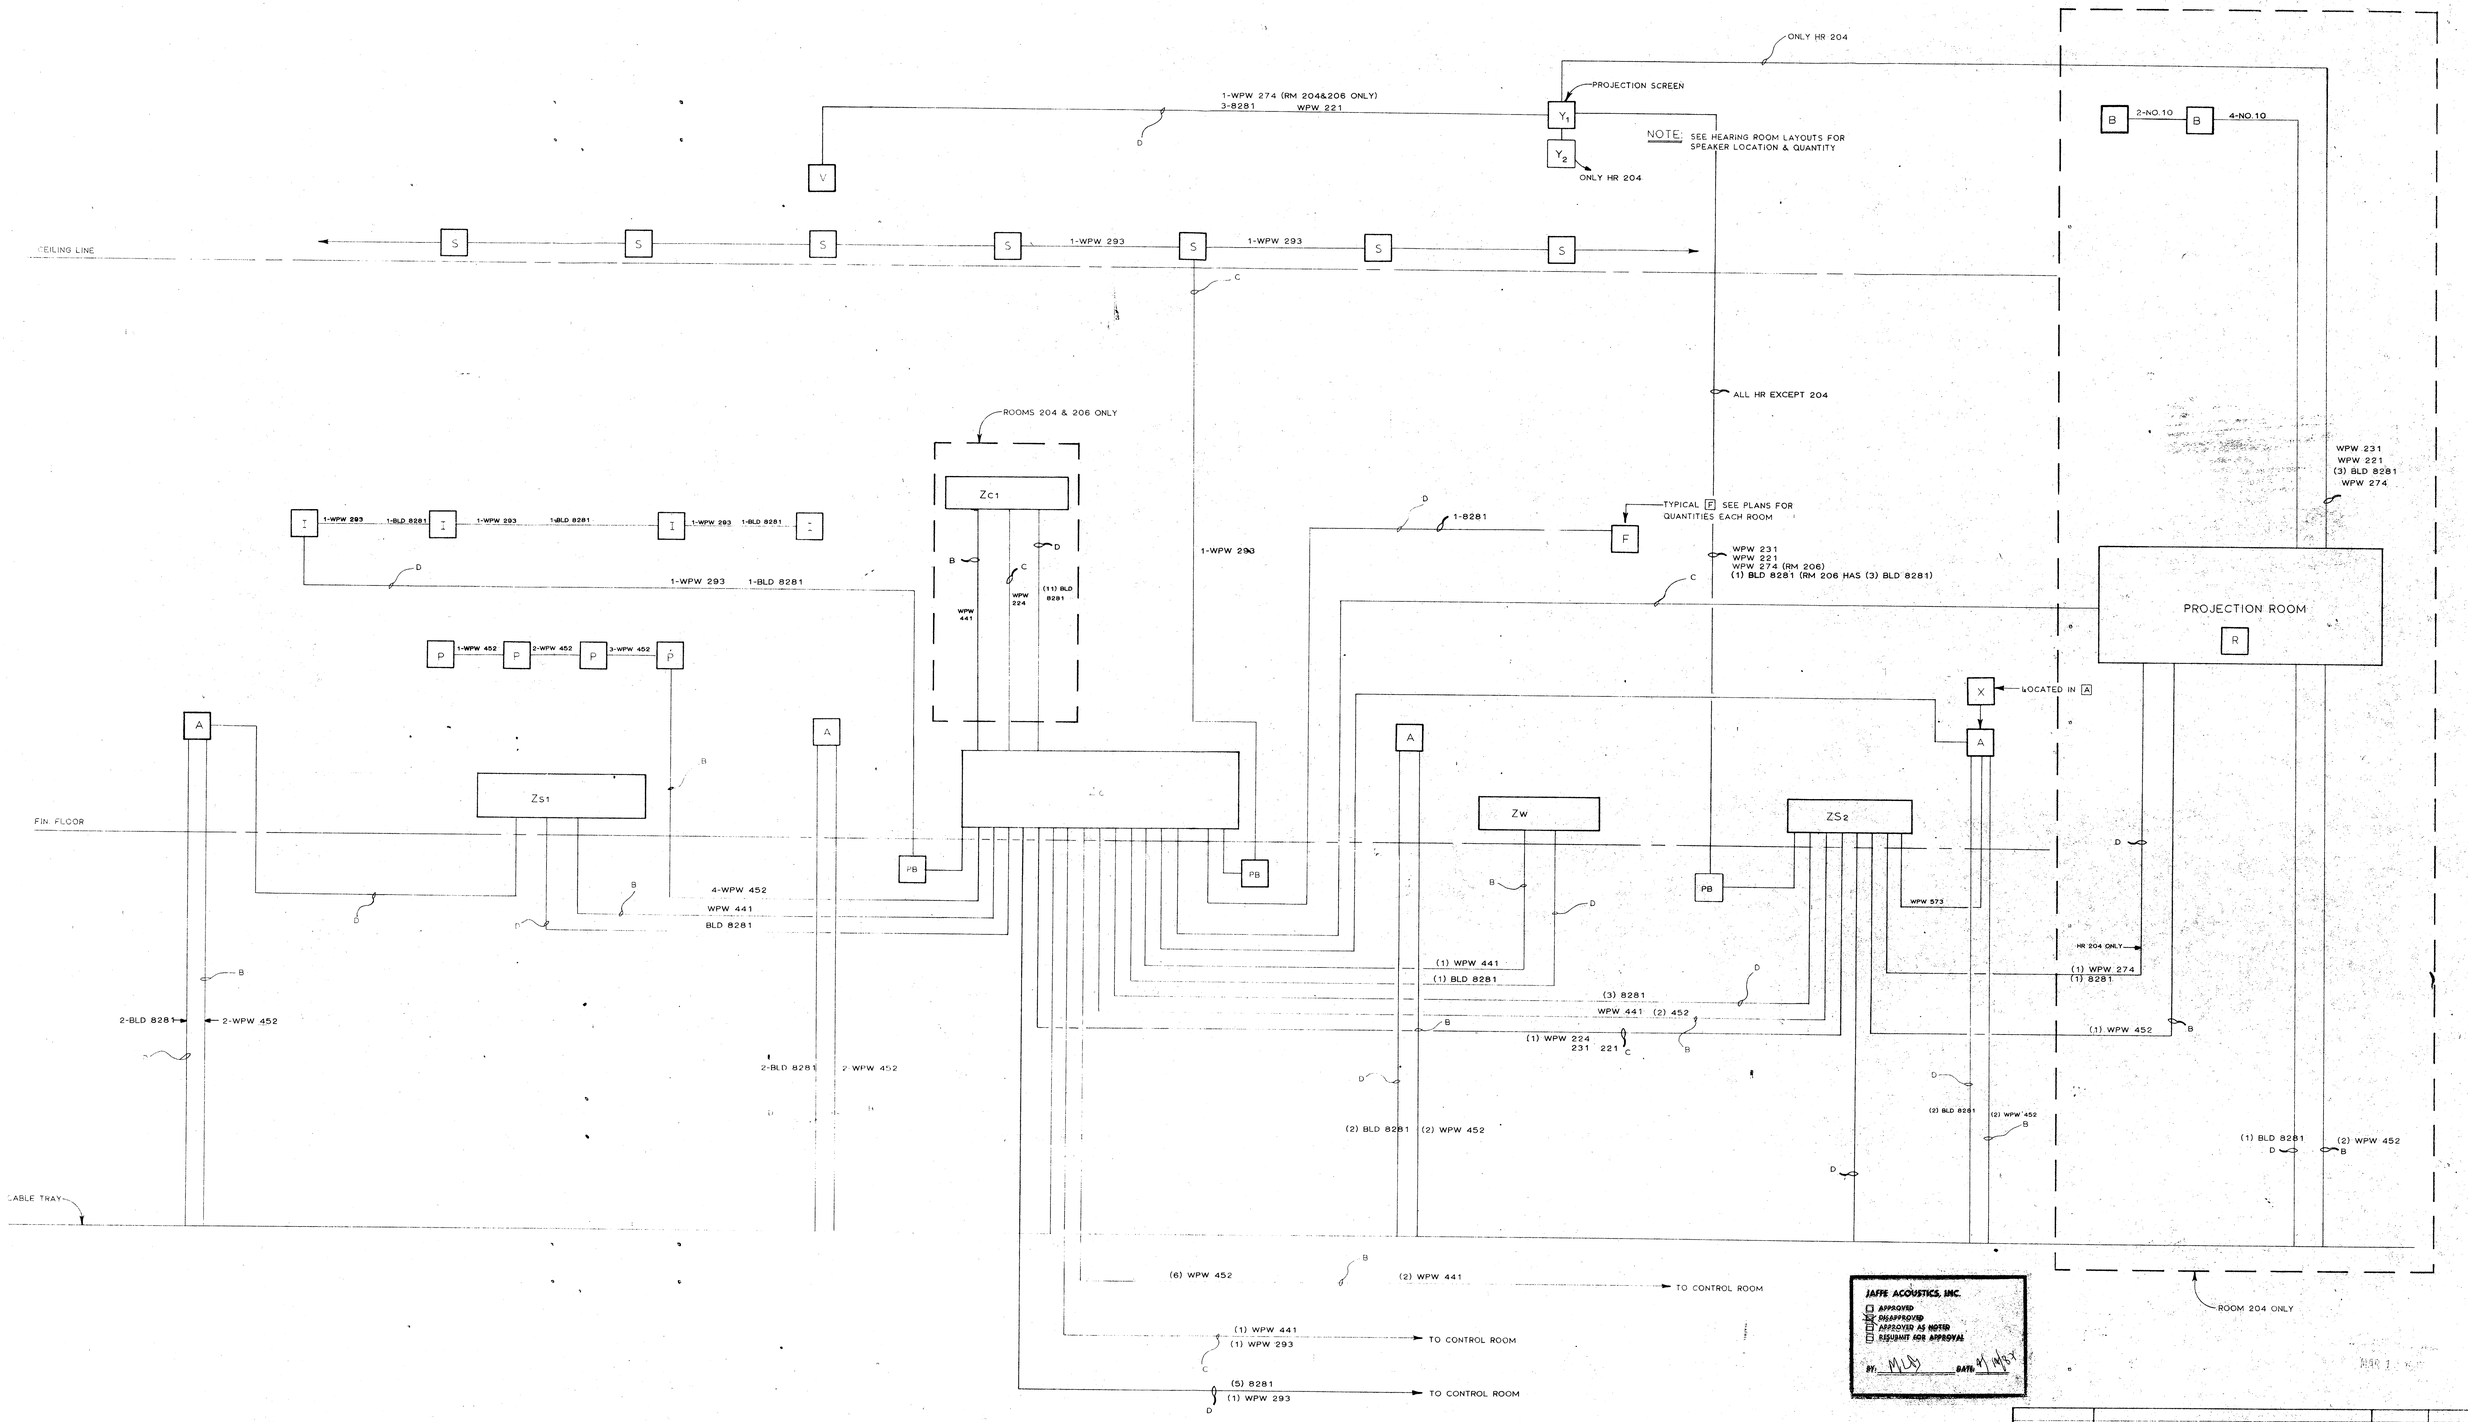

JAFFE ACOUSTICS, INC.
☐ APPROVED
☒ DISAPPROVED
☐ APPROVED AS NOTED
☐ RESUBMIT FOR APPROVAL
BY: MLW DATE: 4 MAY

WIRING GROUP KEY:

GROUP A- MICROPHONES AND OTHER EXTREMELY SENSITIVE WIRING (0-100 MILIVOLTS)

GROUP B- MODERATELY SENSITIVE WIRING (100 MILIVOLTS TO 10 VOLTS)

GROUP C- LOUDSPEAKERS AND CONTROL WIRING (10 VOLTS TO 70 VOLTS)

GROUP D- TELEPHONE,VIDEO,CONTROL AND DIGITAL CIRCUITS.

NOTE: PB = PULL BOX

RISER DIAGRAM TYPICAL OF TYPE I & II HEARING ROOMS. SEE TYPE III & IV HEARING ROOM SCHEMATIC (25700-31) FOR PRECISE WIRE COUNTS.

REVISION	DESCRIPTION	DATE	BY

MIDWEST
ONE SPERTI DRIVE
EDGEWOOD, KY. 41017
TEL.: 606-331-8990
TELEX: 21-4370

TITLE CONNECTICUT LEGISLATIVE PROJECT
HEARING ROOM
CONDUIT RISER DIAGRAM

JOB NO. 25700	DESIGNED BY
DRAWING NO. 25700-29	DRAWN BY TONY R. JAMES
COMPUTER CODE	CHECKED BY
SCALE N/A DATE 2/23/87	APPROVED BY